


XLH05D-001-2016

PLANOS ELÉCTRICOS



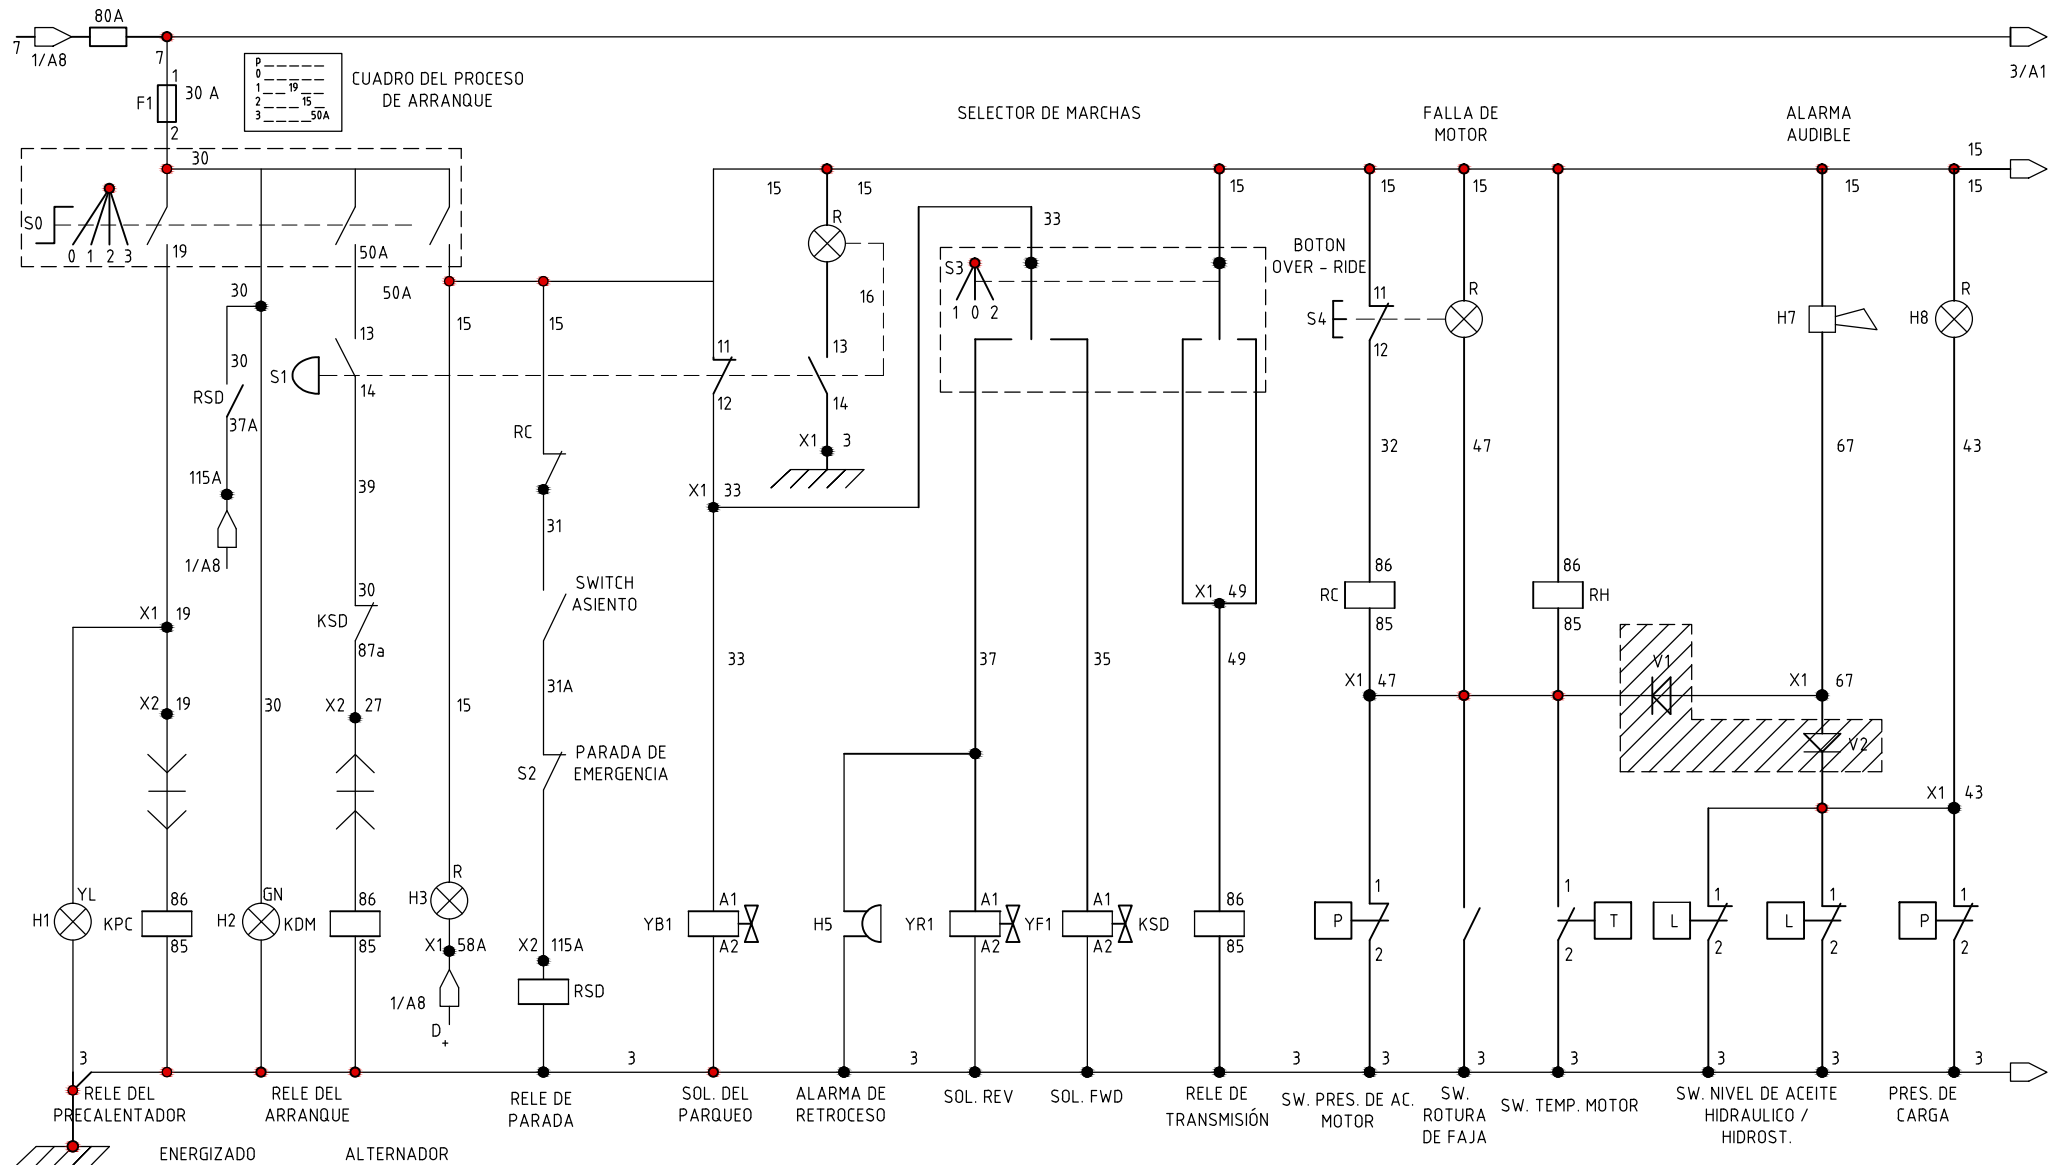

OVERPRIME

DRAWN BY: CARLOS CHAVEZ
 VERIFIED BY: JHON HUAMANI
 APPROVED BY: MARCIO VILCAPOMA
 SCALE: none
 DATE: 01/08/2016
 PROJECT No.: FEI-0040
 DWG: DIAGRAMA ELECTRICO XLH05D .DWG

MICROSCOOP XLH05D

DIAGRAMA ELECTRICO XLH05D

AS BUILT

EMITIDO PARA APROBACION

REV	DESCRIPTION	DATE	BY

NOTAS

DRAWING No.	REVISION	PAGE:
DWG_001	0	2
		CONT. 3

